

**Landworks**  
 Design Group, P.A.  
 7621 Little Ave., Suite 111  
 Charlotte, NC 28226  
 704-841-1604 fax 704-841-1604



**BLUE WATER**  
 DESIGN - BUILD



**PLANTATION ESTATES  
 EXPANSION -  
 TALBOT COURT EXTENSION**  
 MATTHEWS, NC

**PAVEMENT  
 MARKING  
 PLAN**

seals



5/5/15  
 CORPORATE CERTIFICATIONS  
 NC PE: C-253 NC LA: C-253

Description:  
 Per 1st Review Comments  
 (Matthews, LUESA, NCDOT)  
 turn lane striping at Fullwood Ln

REVISIONS:	No.	Date	By	PCL/CPC
	1	3/5/15		
	2	4/16/15	CPC	

Project Manager: TMM

Drawn By: PGJ

Checked By: SSW

Date: 11/12/14


Project Number: 13019

Sheet Number:

**L-801A**

SHEET 3 OF 11

**PLANTATION  
 ESTATES  
 EXPANSION**

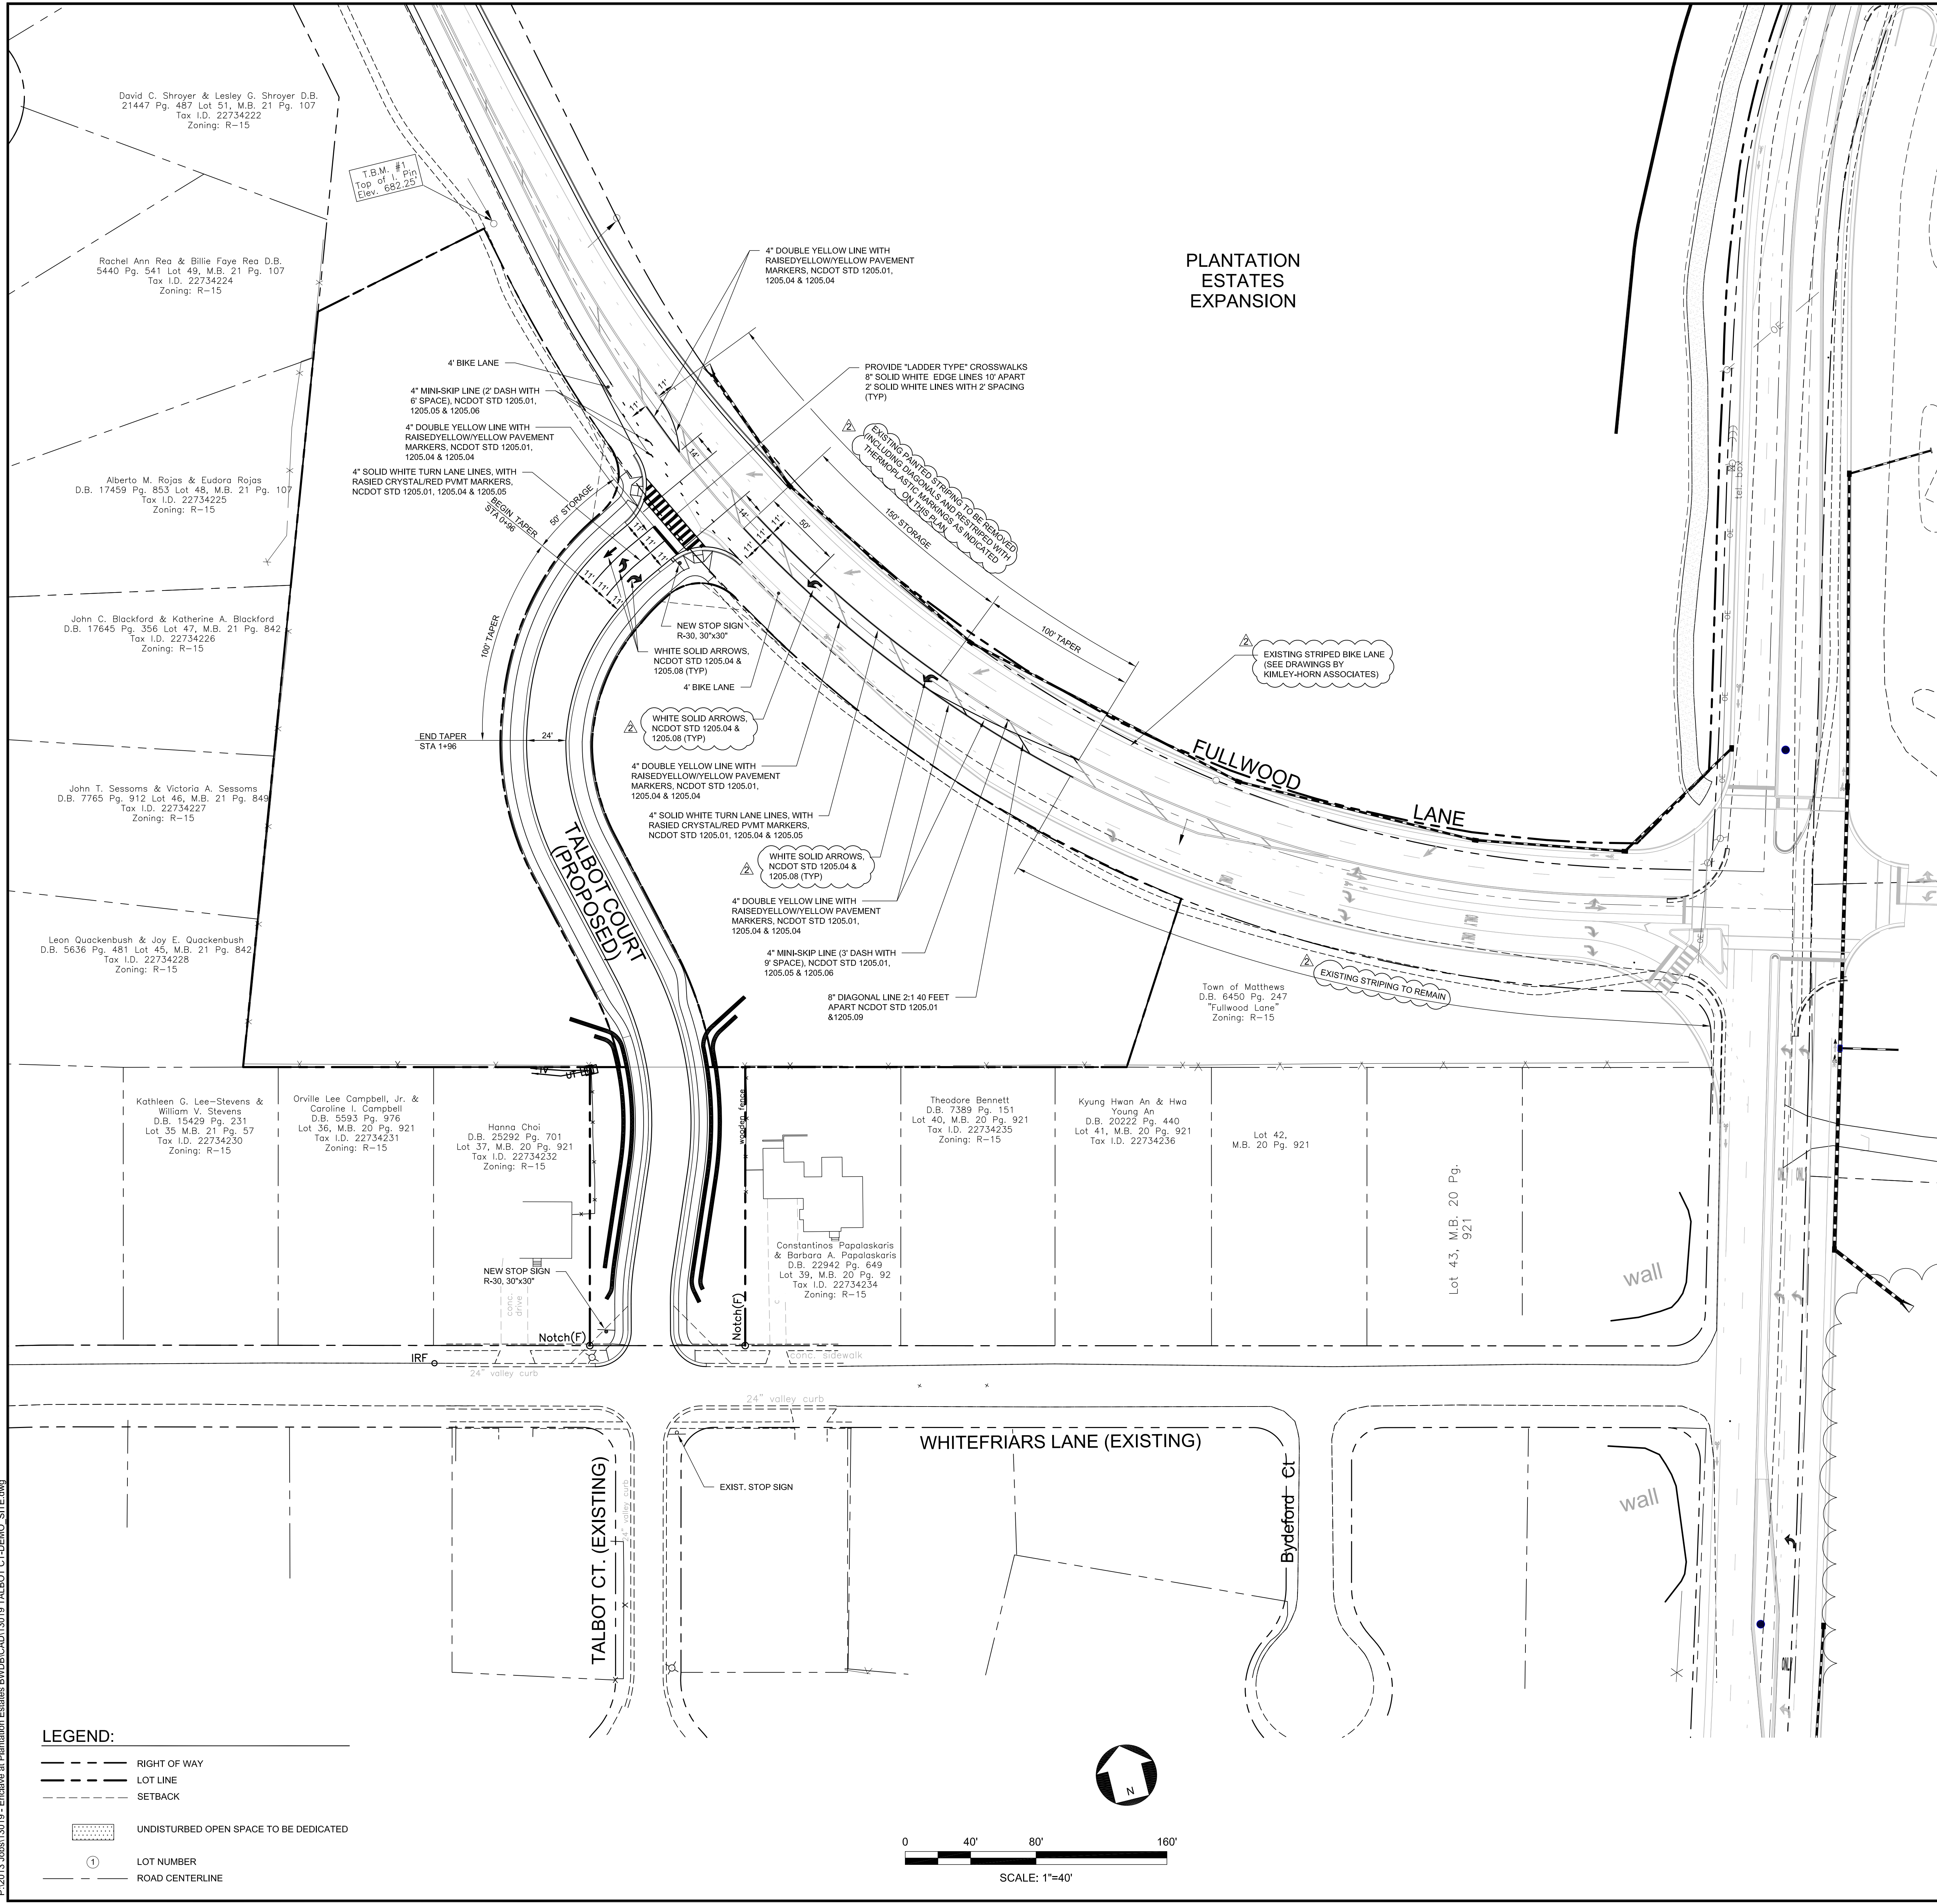

**LEGEND:**

- RIGHT OF WAY
- LOT LINE
- - - SETBACK
- UNDISTURBED OPEN SPACE TO BE DEDICATED
- ① LOT NUMBER
- ROAD CENTERLINE

SCALE: 1"=40'

P:\2013 Jobs\13019 - Endive at Plantation Estates\BWB\CAD\13019 TALBOT CT-CHEMO SITE.dwg